

Jenny Nobbs

From: Carol Ramsden <carol-ramsdend@birketts.co.uk>
Sent: 19 July 2012 08:26
To: Graeme Stark
Subject: Smallcombe Farm Footpath Diversion
Attachments: draftproposalplan190712pdf-V1.pdf

Dear Graeme

Many thanks for your time and your advice on Monday. It was a surprise to both my client and me to learn that we do not have a Definitive Map showing the route as a starting point!

I have prepared the attached plan from which to prepare the order schedule and the order plan, but I am mindful of our lack of information about the existing routes. Please could you supply me a copy of the Definitive Map for the area and the Definitive Statement? - although I appreciate that these won't show any routes! Is there a working copy Map/Statement which does?

I am also keen to establish and understand the grounds for the existence of the routes shown in red on the plan (as opposed to any others) and would be pleased to receive the information upon which the Council is relying in according AQ/BQ and CQ status to these routes, and the formal definitions of these terms.

Are you able to send me the aerial photography to help with the proposed alignment as you kindly offered?

I have obtained a copy of your Public Path Order policy from your website.

I am in the office until lunch time today if it is easier to discuss some of the above.

Many thanks
Carol

Carol Ramsden
Associate (Rights of Way Executive)
For and on behalf of Birketts LLP
Direct Telephone: +(44) (0) 1473 406338
Mobile: 07854 834139
Department Fax: +(44) (0) 1473 406323
carol-ramsdend@birketts.co.uk

For and on behalf of Birketts LLP

Registered office: 24-26 Museum Street, Ipswich, Suffolk, IP1 1HZ

t: +44(0)1473 232300 f: +44(0)1473 230524 DX: 3206 Ipswich

<http://www.birketts.co.uk>

Birketts is a Limited Liability Partnership registered in England under no. OC317545. A list of members is open to inspection at our offices.

Authorised and regulated by the Solicitors Regulation Authority.

CONFIDENTIALITY: This e-mail and any attachments are confidential and may also be privileged. If you are not the named recipient, please notify the sender immediately and do not disclose the contents to another person, use it for any purpose, or store or copy the information in any medium. Although

this e-mail and any attachments are believed to be free from any virus or other defect which might affect any system into which they are opened or received, it is the responsibility of the recipient to check that they are virus free and that they will in no way affect systems and data. No responsibility is accepted by Birketts LLP for any loss or damage arising in any way from their receipt, opening or use.

original application

1/2009

Footpath Diversion Application

Scale 1:2500

Bath & North East Somerset Council
Riverside
Temple Street
Keynsham
Bristol BS31 1LA
Tel 01225 477000

Smallcombe Farm


Footpath to be ~~stopped up~~ ^{diverted}

^{Proposed}

Footpath to be ~~created~~



Compiled by GS on 22 April 2009

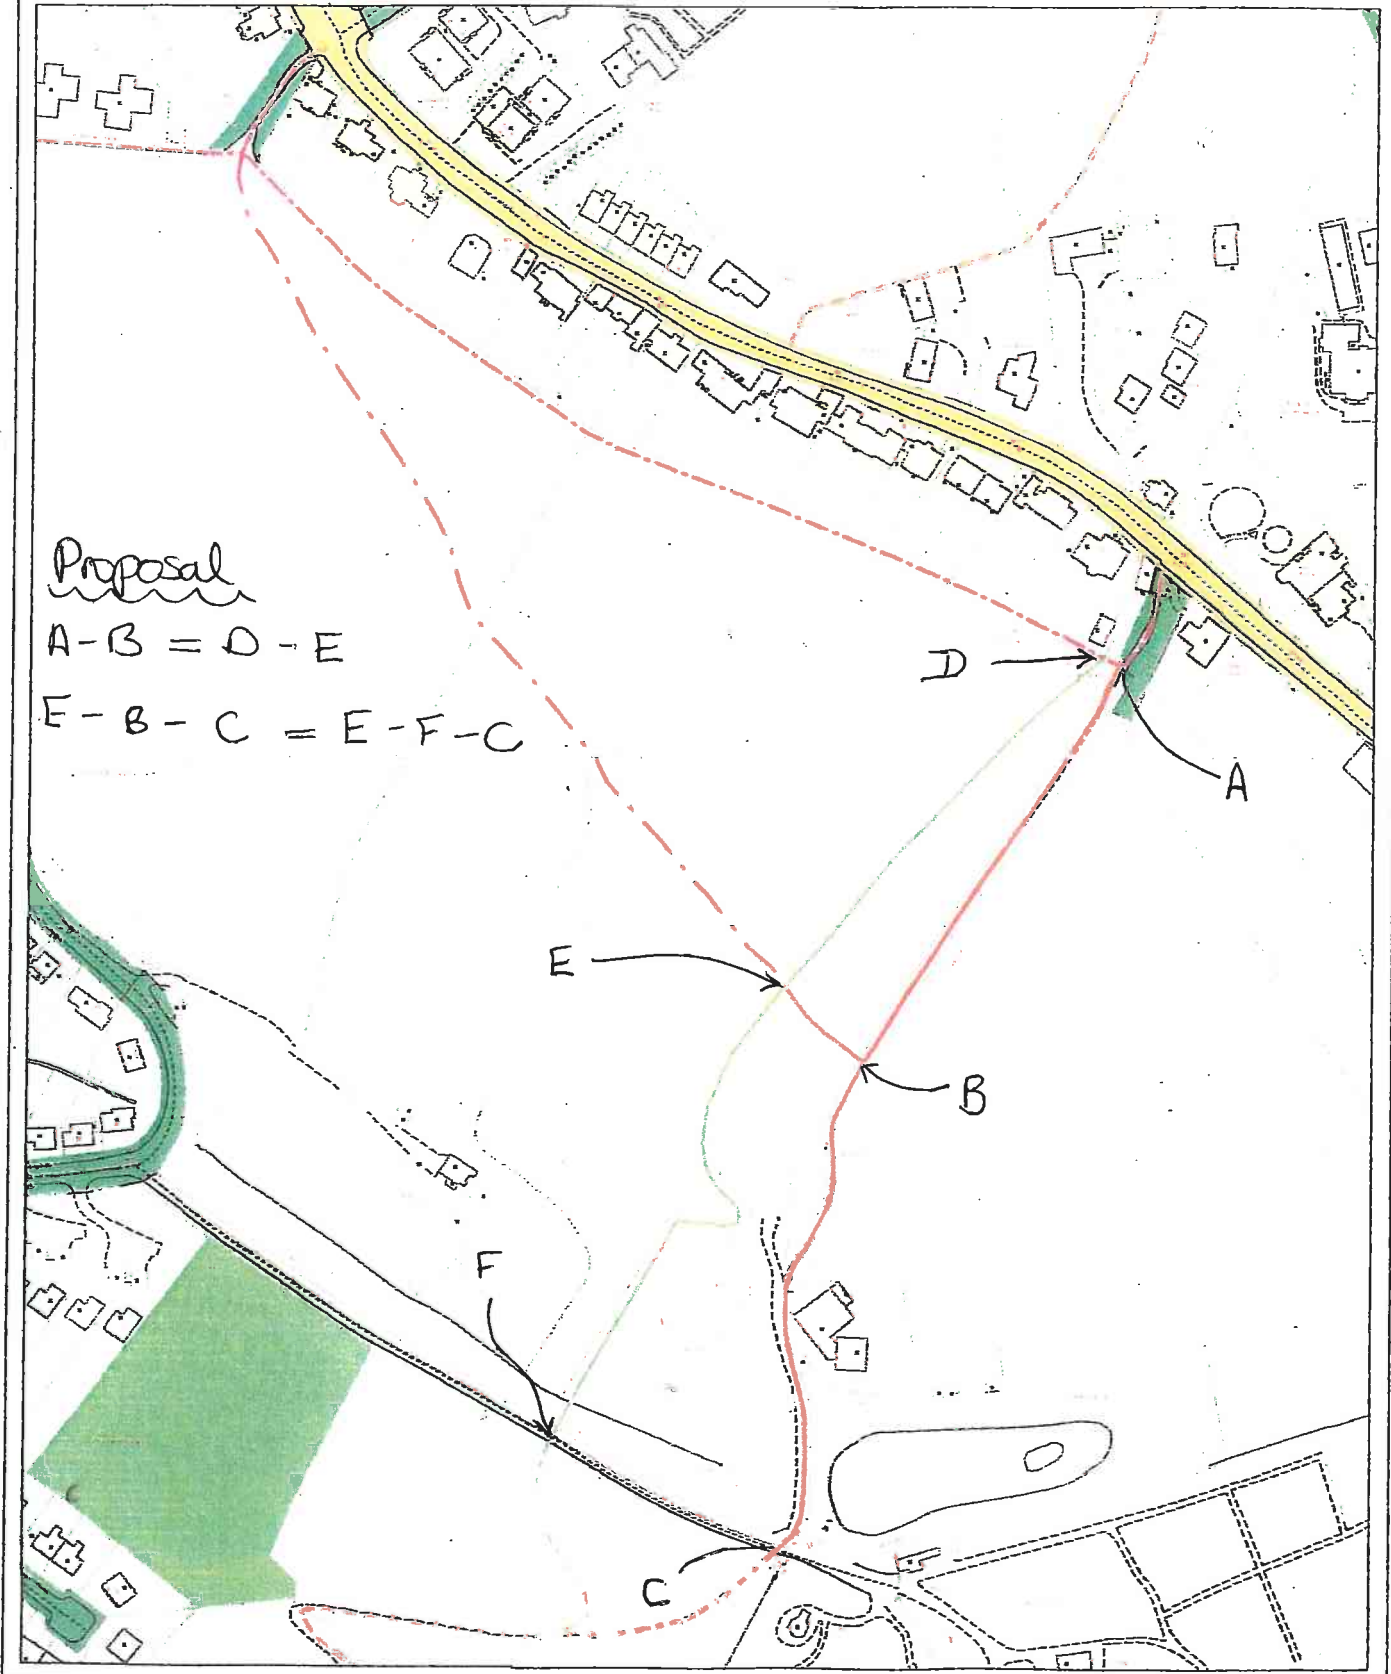

Proposed

A-B = D-E

E-B-C = E-F-C

D

A

E

B

F

C